

Consulting Engineer's Certification:
I, . Dan.Collins hereby certi shown on the plan is a true and correct rec etc., and it corresponds with the relevant app
Signed RPEG

REGISTERED CADASTRAL SURVEYOR (QLD) CERTIFICATION:


LandPartners Pty Ltd, hereby certify that the horizontal and vertical locations, and dimensions shown on this plan are a true and correct record of the As Constructed information.

R. G. andm	4118
Authorised Delegate	Rego No.
_andPartners Pty Ltd	Regente.
Registered Qld Surveyor Corp	poration

tify that the As Constructed information cord of the sizes, types, materials, classes proved Engineering Drawings.

EQ No. 16831 .. Dated .04/12/2024

26/11/2024 Date

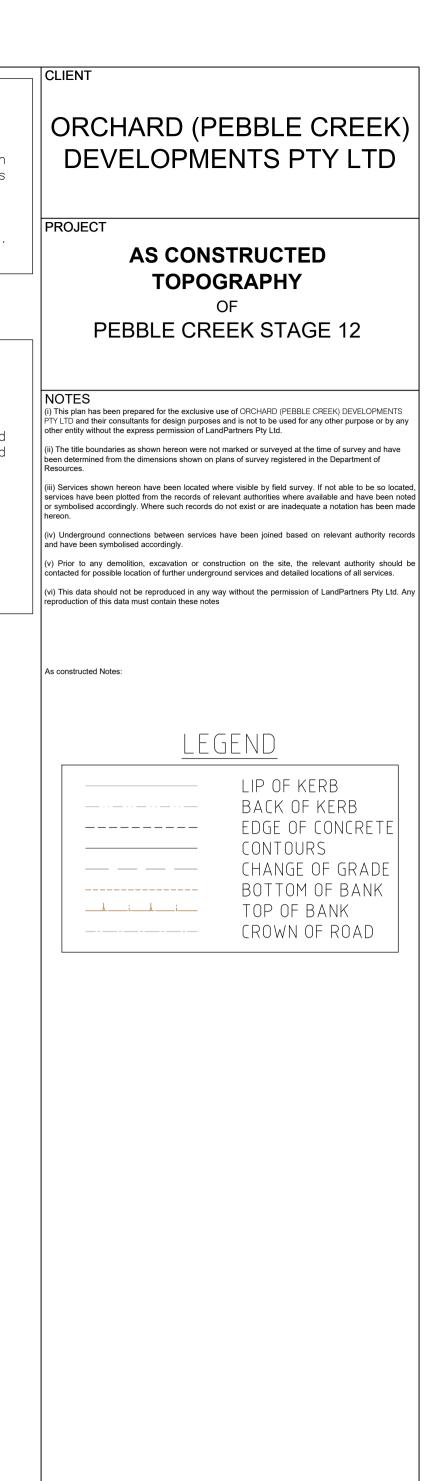

ENGINEERING FIRM:

COLLIERS ENGINEERING & DESIGN PTY LTD

1	26/11/2024	VO	RA	RA	14/10/2024		
REV	DATE	DRAWN	CHECKED	APPROVED	SURVEY DATE		



0m ⊨	5	10	2	0	30m