



Consulting Engineer's Certification:

I, ..... hereby certify that the As Constructed information shown on the plan is a true and correct record of the sizes, types, materials, classes etc., and it corresponds with the relevant approved Engineering Drawings.

Signed..... RPEQ No..... Dated.....

REGISTERED CADASTRAL SURVEYOR (QLD) CERTIFICATION:


LandPartners Pty Ltd, hereby certify that the horizontal and vertical locations, and dimensions shown on this plan are a true and correct record of the As Constructed information.

..... 4118 16/12/2024....  
Authorised Delegate Rego No. Date  
LandPartners Pty Ltd  
Registered Qld Surveyor Corporation

ORCHARD (LOGANVIEW)  
DEVELOPMENTS PTY LTD

AS CONSTRUCTED  
SEWER AND WATER  
OF  
RESIDENTIAL DEVELOPMENT  
LOT 1 ON RP188569

- ALL SEWER RETICULATION PIPES ARE PVC CLASS 'SN8'
- ALL SEWER HOUSE CONNECTION PIPES ARE Ø100 PVC-U CLASS 'SN10' U.N.O
- ALL WATER METERS ARE Ø20 U.N.O.

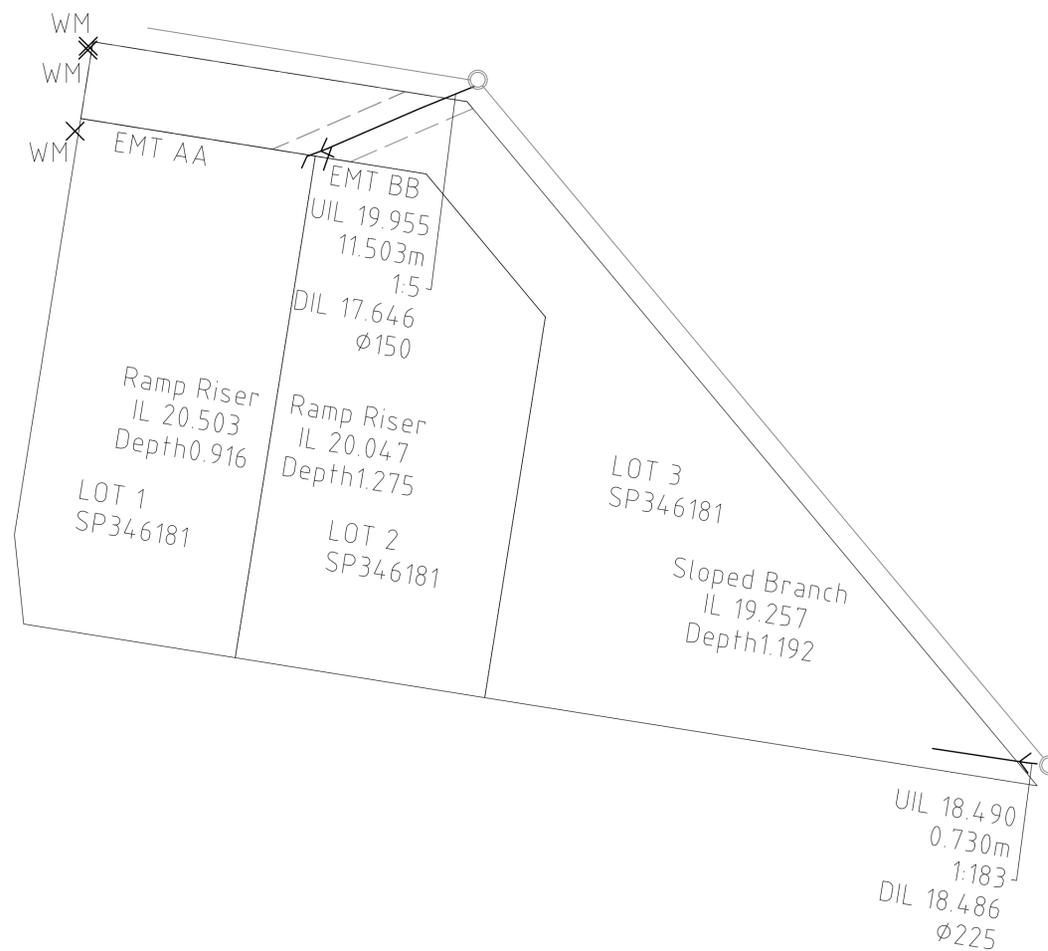

ENGINEERING FIRM:

COLLIERS INTERNATIONAL  
ENGINEERING & DESIGN PTY LTD

REV	DATE	DRAWN	CHECKED	APPROVED	SURVEY DATE
1	16/12/2024	MJK	LS	LS	05/11/2024



Brisbane Office Level 1 18 Little Cribb Street Milton QLD 4064  
PO Box 1399 Milton QLD 4064  
p: (07) 3842 1000 f: (07) 3842 1001 info@landpartners.com.au www.landpartners.com.au

LEVEL DATUM AHD	LOCAL AUTHORITY LOGAN C.C.
LEVEL ORIGIN -	CONTOUR INTERVAL N/A
MERIDIAN MGA84	CO-ORD SYSTEM MGA ZONE 56

UDN SHEET 1 OF 1  
BRSS7540-00A-478-1

