


LEGEND

- (FH) FIRE HYDRANT
- ⊠ (VS) STOP VALVE/(FP) FLUSHING POINT
- ✕ (VA) SCOUR ASSEMBLY
- (RT) READY TAP/(TB) TAPPING BAND
- × (WM) WATER METER (SEQ 20φ)
- └ END CAP
- ├ TEE
- ^ REDUCER
- BEND
- DICL WATER MAIN CROSSING
- - - - CONDUIT/CROSSING
- EXISTING WATER

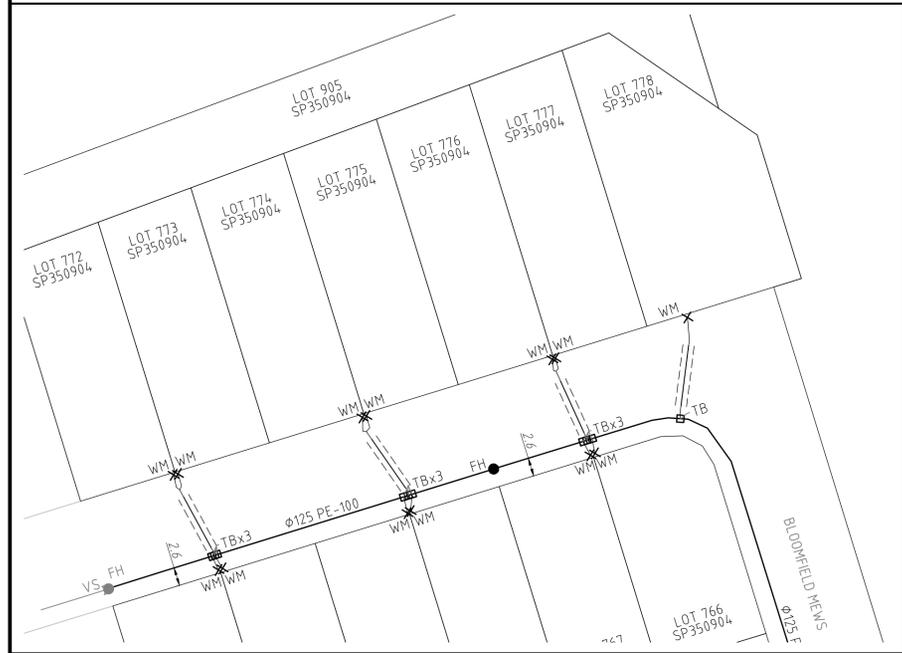

JOINS TO 'A'

NOTES

- ALL FIRE HYDRANTS ARE φ100 SPRING U.N.O.
- ALL WATER SERVICE PIPE CONDUITS ARE φ PVC-M PN12 U.N.O.
- ALL WATER MAIN PIPES ARE PN16 U.N.O.

ENGINEER'S CERTIFICATION


I, _____, hereby certify that the as-constructed details shown on this drawing are a true and accurate record of the construction works in compliance with the contract documents, approved drawings and approved design.

RPEQ (signature) RPEQ No. _____ Date: _____

REGISTERED CADASTRAL SURVEYOR (QLD) CERTIFICATION

LandPartners Pty Ltd, hereby certify that the vertical and horizontal locations and dimensions shown on this plan are a true and accurate record and were located by survey.

C. Walter
 Authorised Delegate Reg. Surveyor No. 4118 Date: 15/01/2026
 LandPartners Pty Ltd
 Registered QLD Surveyor Corporation

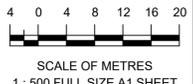

A1

REV NO	DATE	REVISION PURPOSE / DESCRIPTION	DRAWN	RPEQ	RPEQ No
1	15/01/2026	INITIAL ISSUE	MJK		

INITIALS	DATE
DRAWN MJK	15/01/2026
CHECKED CGW	15/01/2026
APPROVED CGW	15/01/2026

MNG
LANDPARTNERS

Brisbane Office
 Level 1
 18 Little Cribb Street
 Milton QLD 4064

p: (07) 3842 1000
 e: brisbane@mnglandpartners.com.au
 w: www.landpartners.com.au

Perth | Brisbane | Melbourne | Sydney | Broome | South West WA

ORCHARD (DALEYS)
 DEVELOPMENTS PTY LTD

AURORA - STAGE 8
 DALEYS ROAD, RIPLEY

AS-CONSTRUCTED
 WATER

DRAWING STATUS	
AS CONSTRUCTED	
SHEET 1 OF 1 SHEETS	
DRAWING NO.	REV.
BRSS5365-O08-101-1	1