Consulting Engineer's Certification:

I, ... hereby certify that the As Constructed information shown on the plan is a true and correct record of the sizes, types, materials, classes etc., and it corresponds with the relevant approved Engineering Drawings.

Signed..... RPEQ No..... Dated.....

REGISTERED CADASTRAL SURVEYOR (QLD) CERTIFICATION:

LandPartners Pty Ltd, hereby certify that the horizontal and vertical locations, and dimensions shown on this plan are a true and correct record of the As Constructed information.

4118		
.....	.....	.....
Authorised Delegate LandPartners Pty Ltd Registered Qld Surveyor Corporation	Rego No.	Date

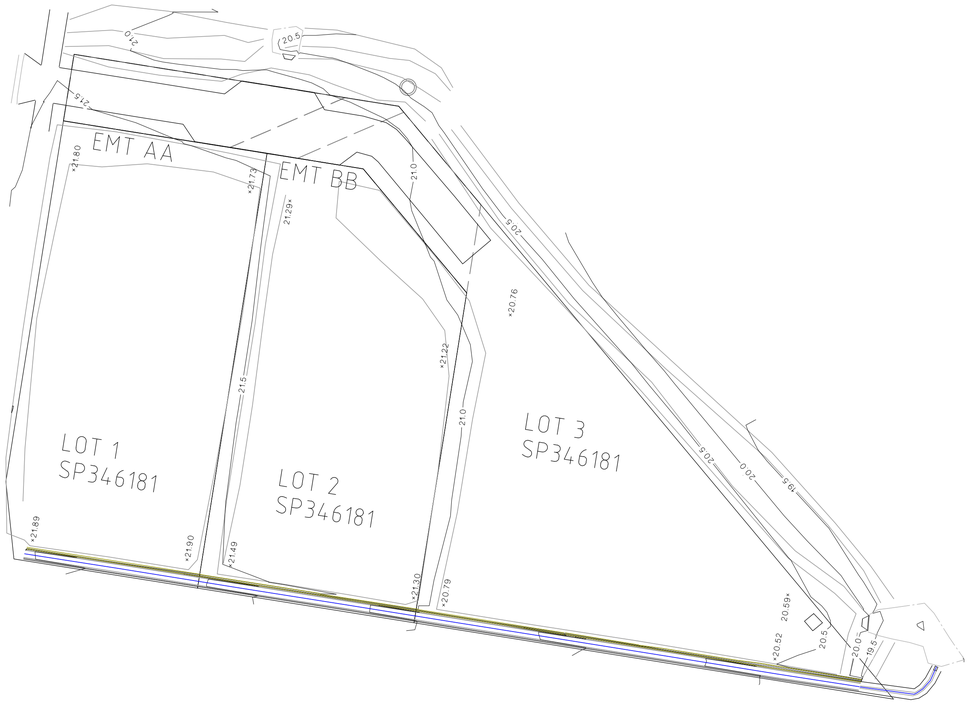

0m 5 10 15m

SCALE 1:250 (A1)

CLIENT

ORCHARD (LOGANVIEW) DEVELOPMENTS PTY LTD

PROJECT

AS CONSTRUCTED TOPOGRAPHY
OF
RESIDENTIAL DEVELOPMENT
LOT 1 ON RP188569

NOTES

LEGEND

- BOTTOM OF WALL
- TOP OF WALL
- LIP OF KERB
- BACK OF KERB
- EDGE OF CONCRETE
- EDGE OF ROCK
- CONTOURS
- CHANGE OF GRADE
- SWALE

ENGINEERING FIRM:

COLLIERS INTERNATIONAL
ENGINEERING & DESIGN PTY LTD

REV	DATE	DRAWN	CHECKED	APPROVED	SURVEY DATE
1	16/12/2024	VO	LS	LS	05/11/2024

LANDPARTNERS surveyors and planners

Brisbane Office
Level 1
18 Little Cribb Street
Milton QLD 4064

PO Box 1399
Milton
QLD 4064

p: (07) 3842 1000
f: (07) 3842 1001
e: info@landpartners.com.au
w: www.landpartners.com.au

LEVEL DATUM	LOCAL AUTHORITY
AHD	LOGAN C.C.
LEVEL ORIGIN -	CONTOUR INTERVAL 0.5 Metre
MERIDIAN MGA94	CO-ORD SYSTEM MGA ZONE 56

UDN SHEET 1 OF 1

BRSS7540-00A-475-1

©LANDPARTNERS 2024