5

RP223192

4

RP223192

Consulting Engineer's Certification:

I, ... hereby certify that the As Constructed information shown on the plan is a true and correct record of the sizes, types, materials, classes etc., and it corresponds with the relevant approved Engineering Drawings.

Signed..... RPEQ No..... Dated.....

REGISTERED CADASTRAL SURVEYOR (QLD) CERTIFICATION:

LandPartners Pty Ltd, hereby certify that the horizontal and vertical locations, and dimensions shown on this plan are a true and correct record of the As Constructed information.

Authorised Delegate LandPartners Pty Ltd Registered Qld Surveyor Corporation	4118 Rego No.	3/07/2025 Date

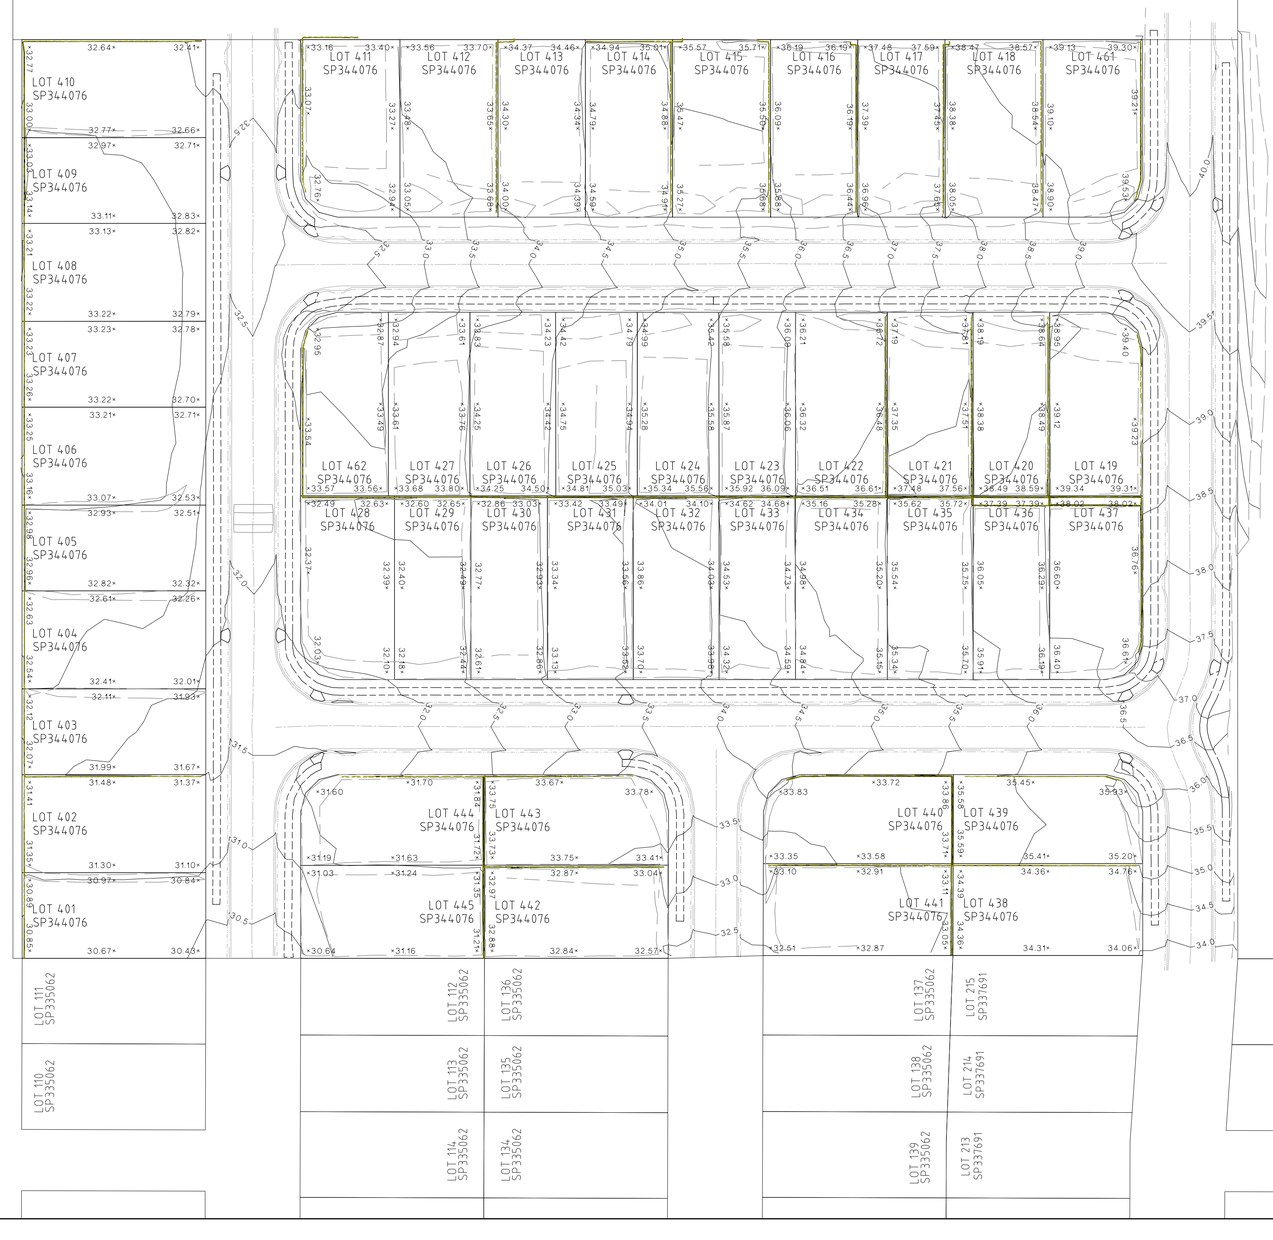

CLIENT

ORCHARD (LOGANVIEW) DEVELOPMENTS PTY LTD

PROJECT

AS CONSTRUCTED TOPOGRAPHY
OF
WILLOW STAGE 4
LOGANVIEW ROAD NORTH LOGAN

NOTES

LEGEND

- BOTTOM OF WALL
- TOP OF WALL
- LIP OF KERB
- BACK OF KERB
- EDGE OF CONCRETE
- INVERT OF KERB
- CONTOURS
- CHANGE OF GRADE
- BOTTOM OF BANK
- TOP OF BANK
- CROWN OF ROAD

ENGINEERING FIRM:
COLLIERS INTERNATIONAL
ENGINEERING & DESIGN PTY LTD

REV	DATE	DRAWN	CHECKED	APPROVED	NOTE
1	03/07/2025	BB	LS	LS	INITIAL ISSUE

MNG LANDPARTNERS
Brisbane Office
Level 1
18 Little Cribb Street
Milton QLD 4064
p: (07) 3842 1000
e: brisbane@mnglandpartners.com.au
w: www.landpartners.com.au
Perth | Brisbane | Melbourne | Sydney | Broome | South West WA

LEVEL DATUM	LOCAL AUTHORITY
AHD	LOGAN C.C.
LEVEL ORIGIN PSM45677 RL:22.874	CONTOUR INTERVAL 0.5 Metre
MERIDIAN MGA94	CO-ORD SYSTEM MGA ZONE 56

UDN SHEET 1 OF 1

BRSS7540-00A-503-1

©LANDPARTNERS 2025